


SUITE #100  
608 S.F.

NORTH  
SECOND FLOOR  
AS-BUILT PLAN  
1801 HOLSER #100  
SCALE: 1/8" = 1'-0"  
SEPTEMBER 04, 2014

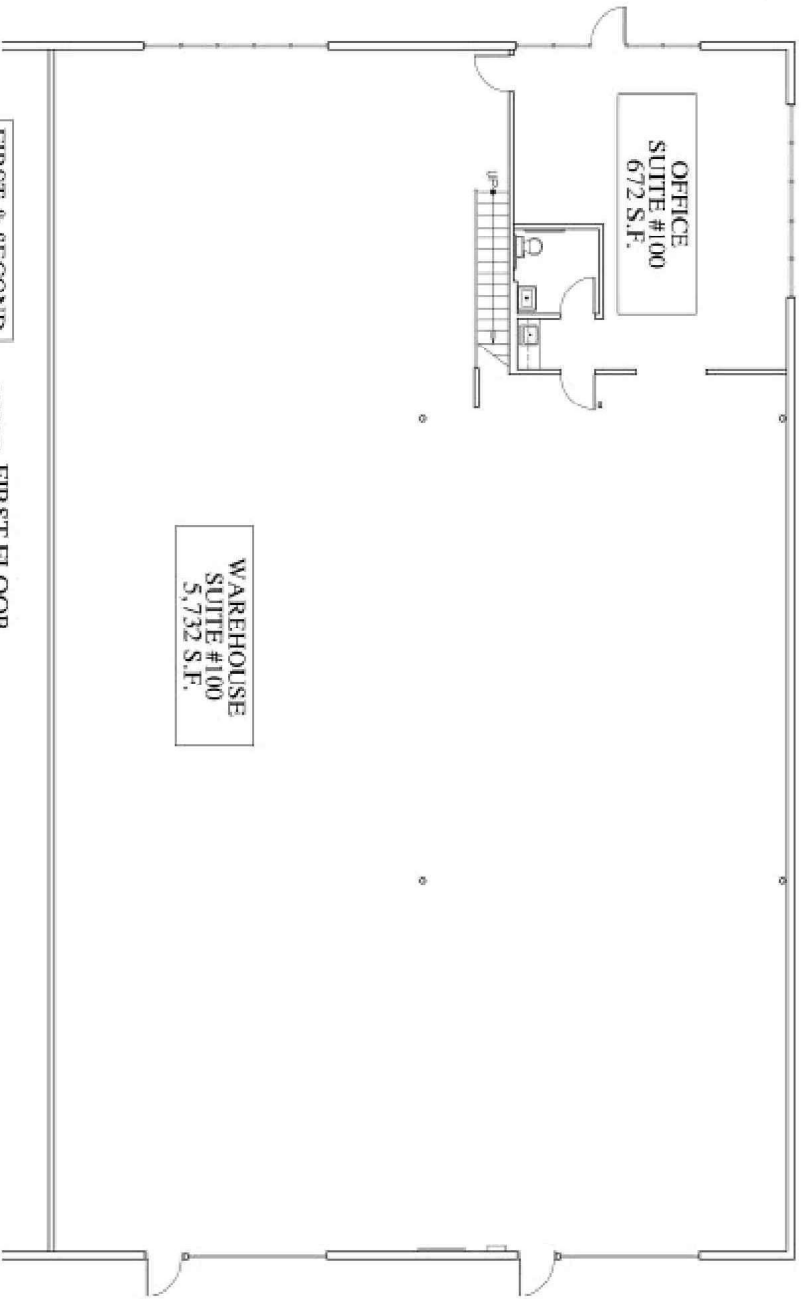

OFFICE  
SUITE #100  
672 S.F.

WAREHOUSE  
SUITE #100  
5,732 S.F.

FIRST & SECOND  
FLOOR TOTAL  
SUITE #100  
7,012 S.F.

NORTH  
FIRST FLOOR  
AS-BUILT PLAN  
1801 HOLSER #100  
SCALE: 1/8" = 1'-0"  
SEPTEMBER 04, 2014